


Proposed Property:

**Lot 4 Melksham Drive
Churton Park
Wellington 6037**

Project #: 000

Designer: Vicky Russell
LBP BP115030 (D1)

*Extra High Wind Zone
Earthquake Zone 3
Ground: D&E*

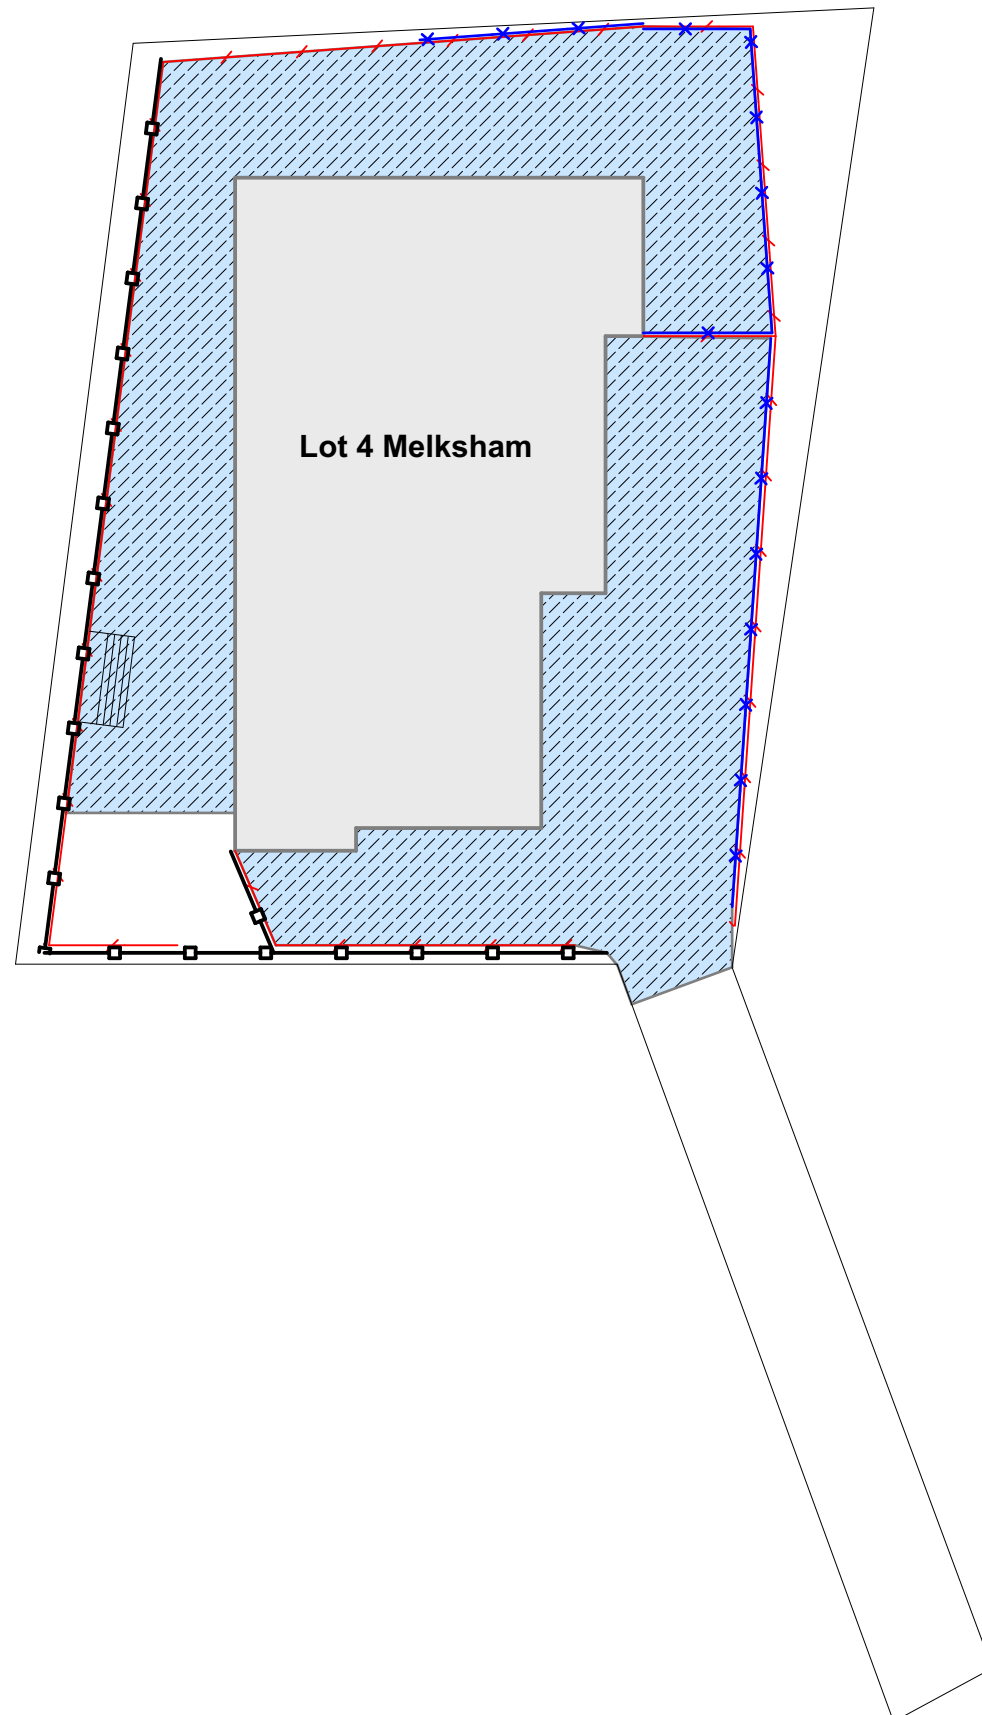

Key

| | |
|--|---------------------------------|
| | Exposed Concrete |
| | Brushed Concrete |
| | Topsoil with Hydroseed grass |
| | Gate |
| | Clothesline |
| | 1.2m 50 or 75 x 25 Paling Fence |
| | 1.2m 150 x 25 Paling Fence |
| | 1.0m 50 x 50 Paling Fence |
| | Retaining Wall |

Materials subject to supply.

Final fence and retaining wall positions to be confirmed on site.

As built on-site 30/07/2021
inc. neighbouring fences

Amendments:

L 01

Issue Date: 30/07/2021

Site Plan

scale: 1:200