Drawing Title

Lot 117 Amesbury Drive Landscape Plan

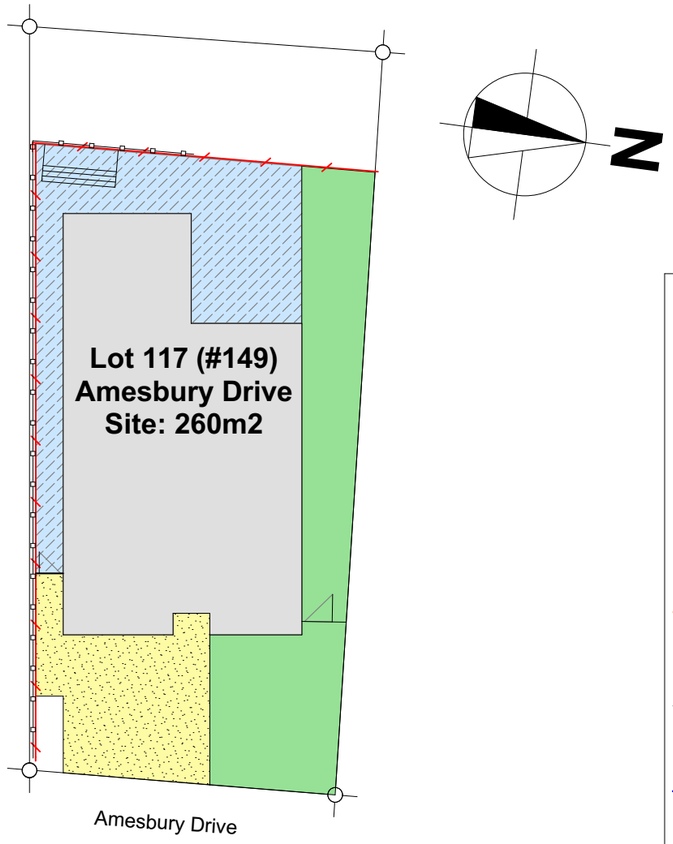

Key

- Exposed Concrete
- Brushed Concrete
- Topsoil with SOE grass
- Gate
- Clothesline
- 1.2m 50 x 20 Paling Fence
- 1.5m 150 x 25 Paling Fence
- 1.0m 50 x 50 Paling Fence
- Retaining Wall

All fences and retaining are as built 13/10/2020

RUSSELL PROPERTIES LTD

Contact: Mike Russell
Mobile: 0274 48 22 33
Office phone: 04 478 4632
Email: mike@russellproperties.co.nz